


- 1) INFORMATION SHOWN HEREON IS BASED ON FIELD SURVEY MEASUREMENTS AND VILLAGE OF GERMANTOWN CONSTRUCTION REPORTS.
- 2) ALL 8" & 6" WATER MAIN PIPE IS A C-900 (PVC) POLYVINYL CHLORIDE PIPE WITH RUBBER GASKET. ALL 2" WATER SERVICES ARE COPPER TUBE SIZE (CTS) SDR 11, HIGH DENSITY POLYETHYLENE (HDPE) TUBING IN ACCORDANCE WITH AWWA C901 AND WERE RECONNECTED TO 1 1/2" COPPER PIPE.
- 3) ALL PIPE SADDLES, FOR TAPPING PVC PIPE, ARE SMITH-BLAIR, STAINLESS STEEL, AND DOUBLE BOLTED. ALL CORPORATION STOPS AND CURB STOPS ARE FORD PRODUCTS.
- 4) ALL GATE VALVES ARE RESILIENT SEATED CLOW PRODUCTS, CONFORMING TO REQUIREMENTS IN AWWA C509. ALL VALVE BOXES ARE 3-PIECE SCREW TYPE AND AN ADAPTER #6 BASE OVER THE VALVE NUT.
- 5) ALL MAIN LINE FITTINGS ARE DUCTILE IRON PIPE WITH A PRESSURE RATING OF 250 PSI WITH COR-BLUE NUTS AND BOLTS WITH A MEGA-LUG JOINT RETAINER GLAND. ALL FITTINGS WERE WRAPPED WITH POLYETHYLENE PLASTIC.
- 6) ALL NEW WATER MAIN PIPE, INCLUDING THE WATER SERVICES WERE EQUIPPED WITH AN INSULATED SOLID COPPER #10 TRACER WIRE. ALL TRACER WIRES TERMINATE IN A VALVED TRACER WIRE ACCESS BOX NEXT TO THE NEW KENNEDY HYDRANTS.

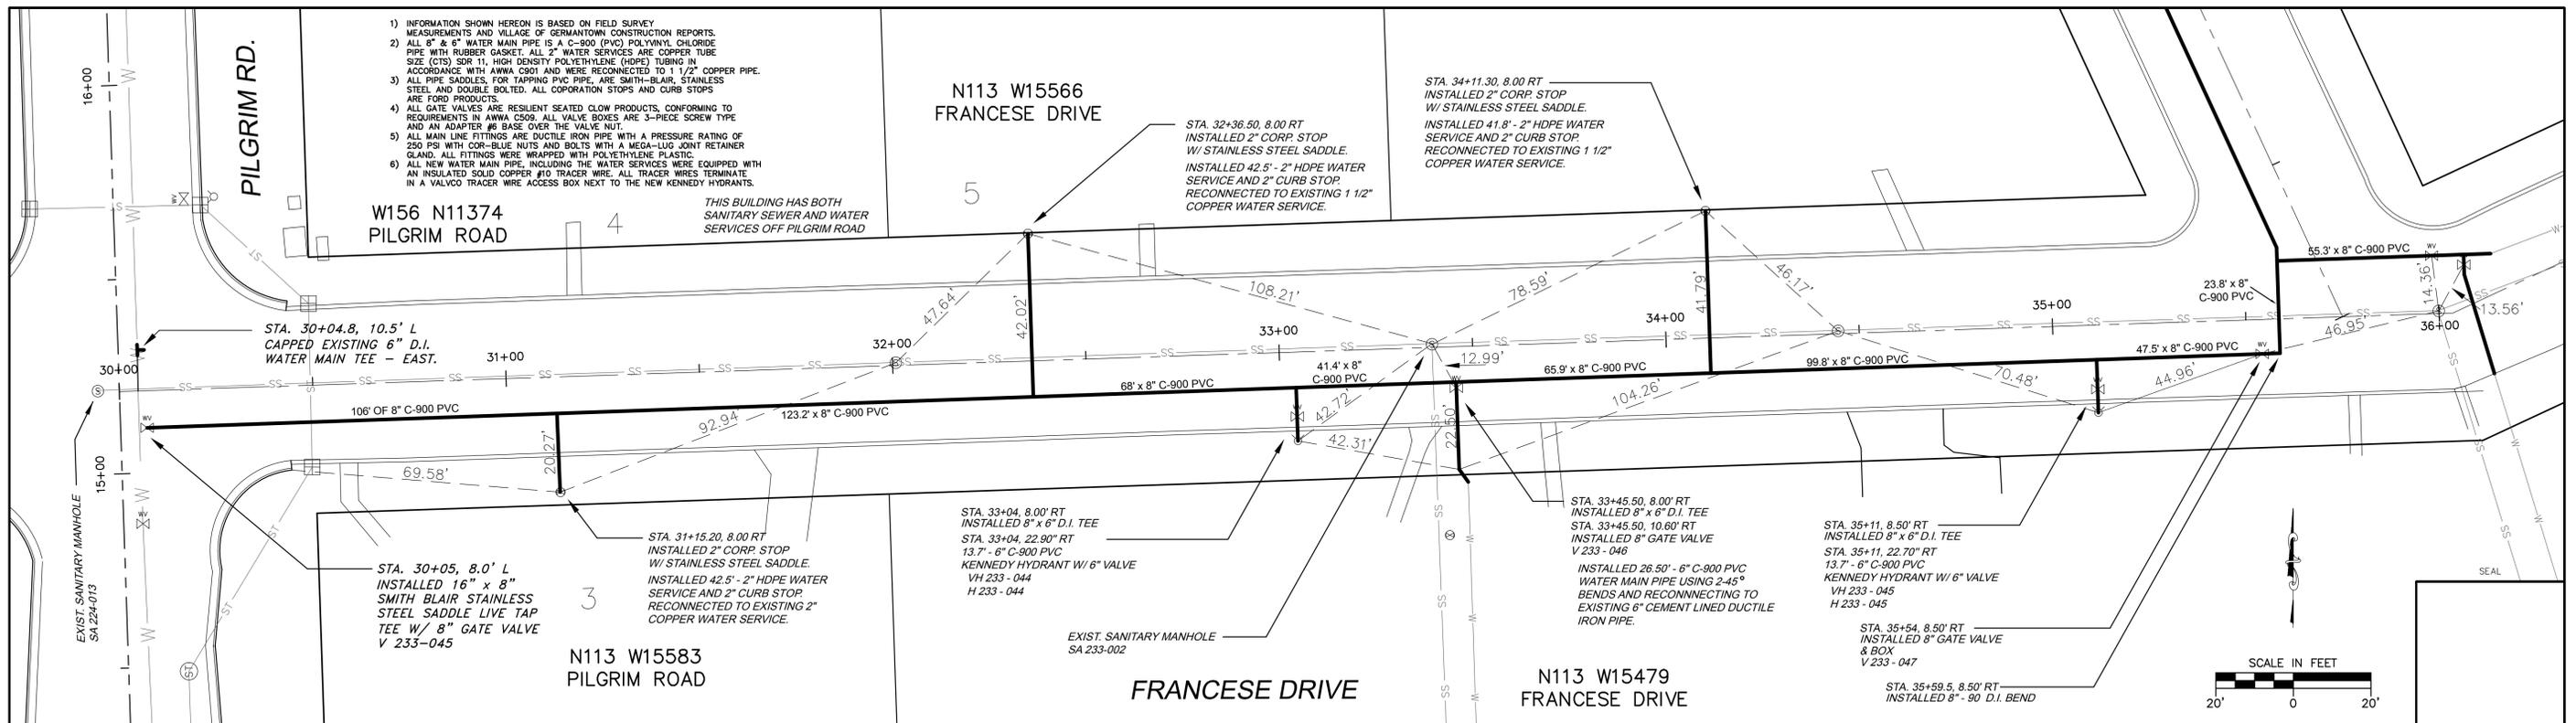


REVISION NO.	DESCRIPTION	DATE	BY

SURVEY BY	RCB	DATE	8/7/2012
DRAWN BY	RCB+FJR	DATE	8/6/2012
APPROVED BY	BRB	DATE	4/22/2013

FRANCESE-SYLVAN WATERMAIN RELAY
WATERMAIN RECORD DRAWING
FRANCESE DRIVE
VILLAGE OF GERMANTOWN, WIS.

CONTRACTOR	WANNASEK
INSPECTION FIRM	VOG
INSPECTOR	FJR
DATE INSTALLED	7/26/2012

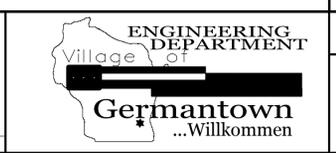

PROJECT NUMBER	1114
SHEET NUMBER	3